

OTTAWA COUNTY ENGINEERS OFFICE

REFERENCE NO. 30-8-14-I
 SE CORNER POST SECTION 30
 BENTON TWP.
 SHEET 1 OF 1.

ROUTE: C-208 ELLISTON-TROWBRIDGE RD.

TOWNSHIP: BENTON


SECTION: 30

T 8 NR 14 E.

NORTHING:

EASTING:

DATUM:

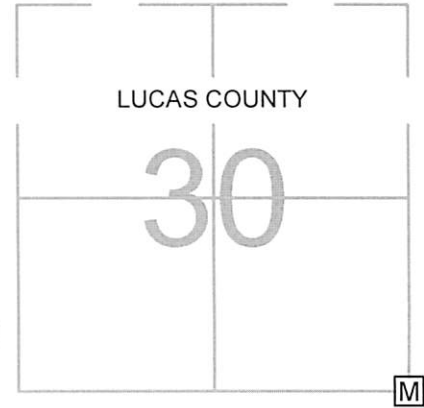


PERSONNEL:
 M. WITTMAN, P.S.
 J. ALLEN

DATE / WEATHER / TEMP:
 JULY 1, 2014
 SUNNY, S-SW
 76° F

MONUMENT INFORMATION

MONUMENT TYPE: SET 1" SQ. I. PIN IN MON BOX
ON SURFACE - BELOW:
 LEFT - CL PAV'T - RIGHT: 2.70'

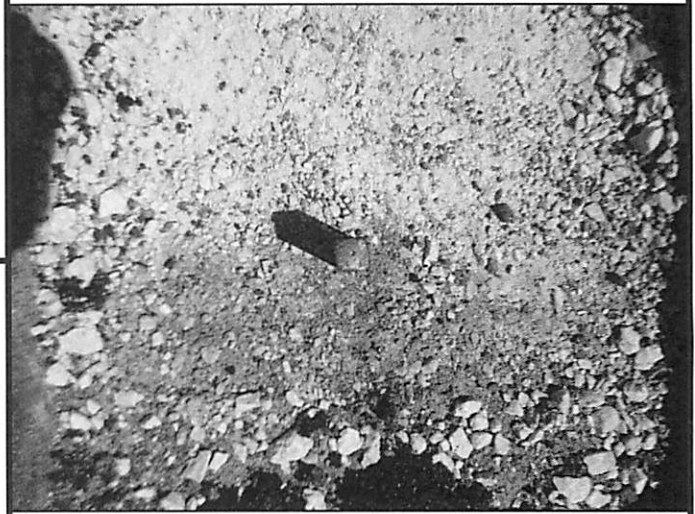

MISC. INFORMATION

7-1-2014 - FD DIG HOLE AT LOCATION, DID NOT FIND RR SPK REFERENCED IN RECENT SURVEYS. DIG HOLE WAS 30' ± FROM IRON PIPE EAST AND IRON PIN WEST. DUG DOWN TO CLAY, PRODDED AND DID NOT FIND STONE. SHOT IRON PIN IN MONUMENT BOX NORTH (NW COR BENTON 29, T8N) AND IRON PIN IN MONUMENT BOX SOUTH (W 1/4 POST BENTON 32 T8N). CALCULATED POINT AS OVERALL DISTANCE BETWEEN POINTS WAS 1.79' SHORT. SPLIT DIFFERENCE BETWEEN IRON PIPE EAST AND IRON PIN WEST AND PRORATED DISTANCES NORTH AND SOUTH TO ESTABLISH POINT.
 7-24-2014 - RETURNED TO SITE AND SET IRON PIN IN MONUMENT BOX.

JULY 24, 2014

SET 1" SQUARE IRON PIN
 IN MONUMENT BOX

