

OTTAWA COUNTY ENGINEERS OFFICE

REFERENCE NO. 31-7-14-G
SW CORNER POST SECTION 31
BENTON TWP.
SHEET 1 OF 1.

ROUTE: C-213 NISSEN RD.
@ S-163 STATE ROUTE 163

TOWNSHIP: BENTON

SECTION: 36

T 7 N R 14 E.


PERSONNEL:
M. WITTMAN, P.S.
J.D. BARNES

NORTHING:

EASTING:

DATUM:

DATE / WEATHER / TEMP:
APRIL 22, 2007
SUNNY S
80° F

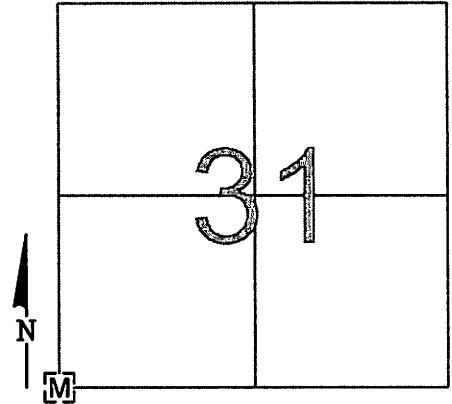

MONUMENT INFORMATION

MONUMENT TYPE: FD 1-1/4" IRON PIN IN MON BOX
ON SURFACE - BELOW:
LEFT - CL PAV'T - RIGHT:

MISC. INFORMATION

8-26-71: FD 8-1/2" x 8-1/2" x 14-1/2" STONE 16"
BELOW SURFACE - SET IRON PIN IN MONUMENT
BOX PER OTTAWA COUNTY STONE RECORDS

PHOTO OF STONE NOT AVAILABLE

