

OTTAWA COUNTY ENGINEERS OFFICE


REFERENCE NO. 31-7-14-H
S QUARTER POST SECTION 31
BENTON TWP.
SHEET 1 OF 1.

ROUTE: S-163 STATE ROUTE #163
TOWNSHIP: BENTON
SECTION: 31
T 7 NR 14 E.

PERSONNEL:
R. STEINMILLER, P.S.
J. UNDERWOOD
T. THORBAHN
J. CRONON - ODOT

NORTHING:
EASTING:
DATUM:

DATE / WEATHER / TEMP:
JUNE 11, 1986
CLDY - SW
75° F (HUMID)

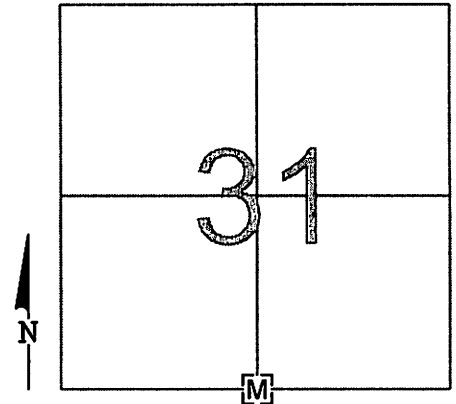

MONUMENT INFORMATION


MONUMENT TYPE: FD 1-1/4" IRON PIN IN MON BOX
ON SURFACE - BELOW:
LEFT - CL PAV'T - RIGHT: 3' +/-

PHOTO OF STONE NOT AVAILABLE

MISC. INFORMATION

6-11-1986: R. STEINMILLER, P.S., J. UNDERWOOD, T. THORBAHN
AND J. CRONIN FROM ODOT - FD BOAT SPIKE 1-1/2" BELOW
SURFACE. SET SHORT PK TIES 2.00' NORTH AND 2.00' WEST. FD
5-1/2" x 6" x 10" SQUARE TOP LIMESTONE 1.38' BELOW THE
SURFACE - SET IRON PIN IN MONUMENT BOX

THERE IS ANOTHER IRON PIN IN A MONUMENT BOX 3' +/- SOUTH
OF POINT THAT MARKS THE C/L OC CONSTRUCTION OF SR #163.

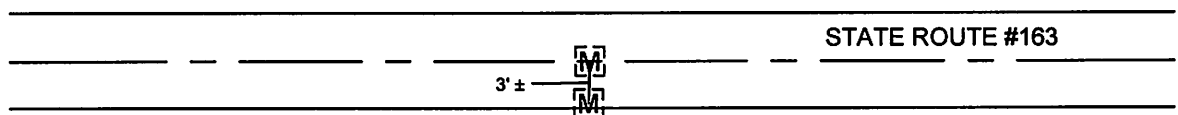

USING SHORT TIES
PK N - 2.28'
PK W - 2.405'

PI C/L CONSTRUCTION
IRON PIN IN MON BOX
SOUTH OF N 1/4 POST