

OTTAWA COUNTY ENGINEERS OFFICE

REFERENCE NO. 31-7-14-I
 SE CORNER POST SECTION 31
 BENTON TWP.
SHEET 1 OF 1.

ROUTE: C-208 ELLISTON-TROWBRIDGE RD.
 @ S-163 STATE ROUTE 163

TOWNSHIP: BENTON

SECTION: 31

T 7 **NR** 14 **E.**


NORTHING:

EASTING:

DATUM:

PERSONNEL:
 M. WITTMAN, P.S.
 J.D. BARNES

DATE / WEATHER / TEMP:
 APRIL 22, 2007
 SUNNY S
 80° F

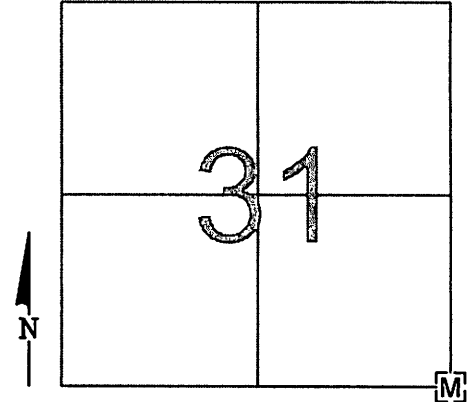

MONUMENT INFORMATION

MONUMENT TYPE: FD 1-1/4" IRON PIN IN MON BOX
 ON SURFACE - BELOW:
 LEFT - CL PAV'T - RIGHT:

MISC. INFORMATION

5-29-1986: R. STEINMILLER, P.S., J. UNDERWOOD,
 T. THORBAHN AND J. CRONIN FROM ODOT - FD
 8-1/2" x 5-1/2" x 6" STONE 18-1/2" BELOW SURFACE
 - SET IRON PIN IN MONUMENT BOX

POINT FOR C/L CONSTRUCTION OF S.R. #163 IS
 APPROX. 1' S. OF NE COR POST

PHOTO OF STONE NOT AVAILABLE

NEW TIES: 4-22-2007
 M. WITTMAN, P.S.
 J.D. BARNES

