

OTTAWA COUNTY ENGINEERS OFFICE

REFERENCE NO. 31-8-14-A
NW CORNER POST SECTION 31
BENTON TWP.
SHEET 1 OF 1.

ROUTE: C-213 NISSEN RD.

TOWNSHIP: BENTON

SECTION: 31

T 8 NR 14 E.

PERSONNEL:
M. WITTMAN, P.S.
J. ALLEN


NORTHING:

EASTING:

DATUM:

DATE / WEATHER / TEMP:

JULY 25, 2014
SUNNY
74° F

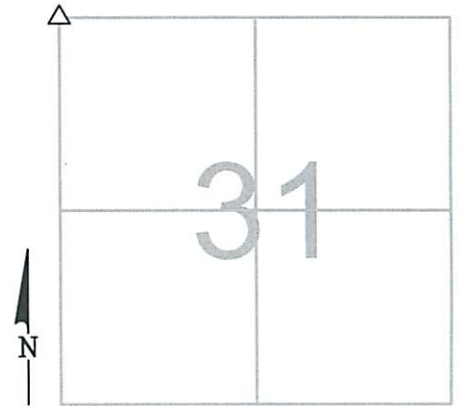

MONUMENT INFORMATION

MONUMENT TYPE: FD 9" X 6" LIMESTONE W/ DH
ON SURFACE - BELOW: 1.94'
LEFT - CL PAV'T - RIGHT: 7.80'

USED DH IN STONE.



MISC. INFORMATION

FD. RR SPK 0.42' BELOW SURFACE, TIED W/ X-TIES
AND DUG FOR STONE.

RR SPK WAS 0.10' WEST AND 0.04' SOUTH OF DH IN
STONE.

THIS IS A CLOSING CORNER.

JULY 25, 2014

SET 1" SQUARE IRON PIN
IN MONUMENT BOX OVER
STONE

