

OTTAWA COUNTY ENGINEERS OFFICE

REFERENCE NO. 31-8-14-D
WEST QUARTER POST SEC. 31
BENTON TWP.
SHEET 1 OF 1.

ROUTE: C-213 NISSEN RD.

TOWNSHIP: BENTON

SECTION: 31

T 8 NR 14 E.

PERSONNEL:
M. WITTMAN, P.S.
J. ALLEN


NORTHING:

EASTING:

DATUM:

DATE / WEATHER / TEMP:

JULY 28, 2014
PTLY SUNNY, N-NW
68° F

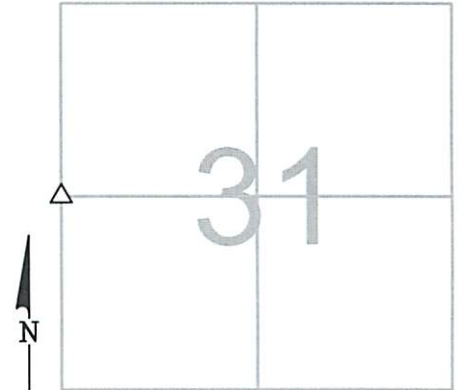

MONUMENT INFORMATION

MONUMENT TYPE: 8" X 5" POINTED LIMESTONE
ON SURFACE - BELOW: 0.77'
LEFT - CL PAV'T - RIGHT: 1.20'

SET DH IN HIGH POINT ON STONE.



MISC. INFORMATION

FD.HARROW TOOTH ON SURFACE, TIED W/ GPS
AND DUG FOR STONE. HARROW TOOTH WAS 0.12'
EAST AND 0.01' NORTH OF DH SET IN STONE.

THIS IS A CLOSING CORNER.

JULY 28, 2014

SET 1" SQUARE IRON PIN
IN MONUMENT BOX OVER
STONE

