

OTTAWA COUNTY ENGINEERS OFFICE

REFERENCE NO. 31-8-14-F
EAST QUARTER POST SEC. 31
BENTON TWP.
SHEET 1 OF 1.

ROUTE: C-208 ELLISTON-TROWBRIDGE RD.

TOWNSHIP: BENTON

SECTION: 31


T 8 NR 14 E.

PERSONNEL:
M. WITTMAN, P.S.
J. ALLEN

NORTHING:

EASTING:

DATUM:

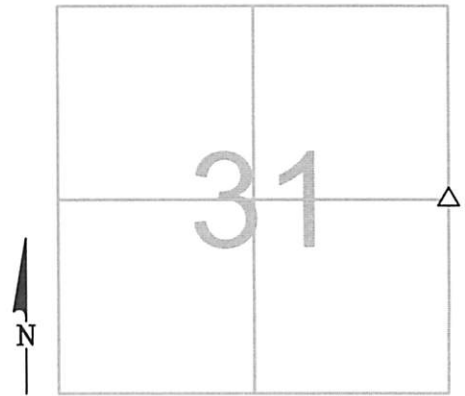

DATE / WEATHER / TEMP:

JUNE 30, 2014
PTLY SUNNY, S
82° F

MONUMENT INFORMATION

MONUMENT TYPE: FD RECTANGULAR LIMESTONE
ON SURFACE - BELOW: 1.58'
LEFT - CL PAV'T - RIGHT: 4.85'

STONE IS 8" X 4" X 8" - LEANING SW WITH SE CORNER
BROKEN OFF.

USED CENTER OF STONE.



MISC. INFORMATION

FD RR SPIKE 0.12' BELOW SURFACE, TIED W/ X-TIES
AND DUG FOR STONE. RR SPK WAS 0.22' EAST AND
0.15' NORTH OF CENTER OF STONE.

JUNE 30, 2014

SET 1" SQUARE IRON PIN
IN MONUMENT BOX OVER
STONE

