

# OTTAWA COUNTY ENGINEERS OFFICE

REFERENCE NO. 32-7-14-A  
NW CORNER POST SEC. 32  
BENTON TWP.  
SHEET 1 OF 1.

PERSONNEL:  
M. WITTMAN, P.S.  
J. ALLEN

DATE / WEATHER / TEMP:  
MARCH 22, 2012  
SUNNY  
68° F

ROUTE: C-208 ELLISTON-TROWBRIDGE RD.  
@ T-55 SOUTH TOUSSAINT RD.

TOWNSHIP: BENTON


SECTION: 32

T 7 NR 14 E.

NORTHING:

EASTING:

DATUM:

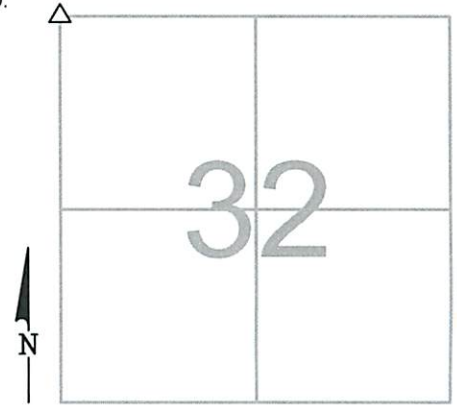

## MONUMENT INFORMATION

MONUMENT TYPE: 9" X 9" GRANITE STONE  
ON SURFACE - BELOW: 1.57'  
LEFT - CL PAV'T - RIGHT: 5.30'  
STONE IS ROUND AND FLAT

USED CENTER OF STONE



## MISC. INFORMATION

MARCH 22, 2012

SET 1" SQUARE IRON PIN  
IN MONUMENT BOX OVER  
STONE

