

# OTTAWA COUNTY ENGINEERS OFFICE

REFERENCE NO. 32-7-14-C  
 NE CORNER POST SEC. 32  
 BENTON TWP.  
 SHEET 1 OF 1.

ROUTE: C-19 GRAYTOWN RD.  
 @ T-78 SONDERGELD RD.

TOWNSHIP: BENTON

SECTION: 32

T 7 NR 14 E.


NORTHING:

EASTING:

DATUM:

PERSONNEL:  
 M. WITTMAN, P.S.  
 J. ALLEN

DATE / WEATHER / TEMP:  
 MARCH 26, 2012  
 SUNNY - NE  
 38° F

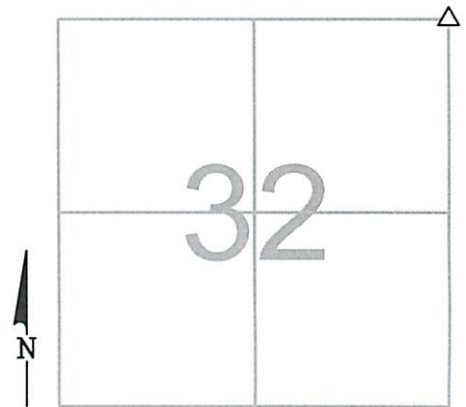

### MONUMENT INFORMATION

MONUMENT TYPE: FD. 9"X13-1/2" HARDHEAD STONE  
 ON SURFACE - BELOW: 0.93'  
LEFT - CL PAV'T - RIGHT: 2.40'  
  
 9-1/2" HARROWTOOTH SLANTED OVER STONE  
  
 SET DRILL HOLE IN CENTER OF STONE



### MISC. INFORMATION

FD. MAG SPIKE ON SURFACE W/ 2' TIES N, S, E & W  
 DUG FOR IRON PIN PER RECORDS  
 HARROWTOOTH FD SLANTED OVER NE COR OF STONE  
 NO VISIBLE MARKINGS ON STONE  
 CENTER OF HARROWTOOTH WHICH WAS UNDER MAG  
 SPIKE WAS 0.20' N AND 0.25' E OF CENTER OF STONE

MARCH 26, 2012

SET MONUMENT BOX  
 OVER STONE

