

OTTAWA COUNTY ENGINEERS OFFICE

REFERENCE NO. 32-7-14-D
W QUARTER POST SECTION 32
BENTON TWP.
SHEET 1 OF 1.

PERSONNEL:
M. WITTMAN, P.S.
M. BROUGH

DATE / WEATHER / TEMP:
JULY 22, 2003
CLDY N
76° F

ROUTE: C-208 ELLISTON TROWBRIDGE RD.

TOWNSHIP: BENTON


SECTION: 32

T 7 NR 14 E.

NORTHING:

EASTING:

DATUM:

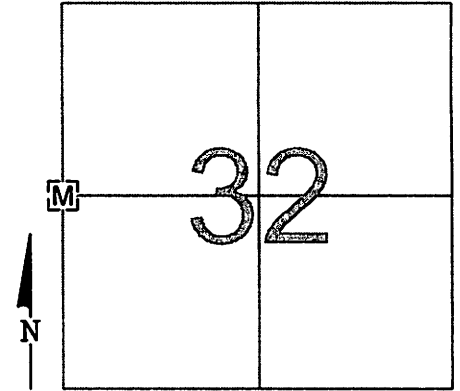


MONUMENT INFORMATION

MONUMENT TYPE: FD 1" SQ. IRON PIN IN MON BOX
ON SURFACE - BELOW: 0.06'
LEFT - CL PAV'T - RIGHT: 7.19'

MISC. INFORMATION

PHOTO OF STONE NOT AVAILABLE

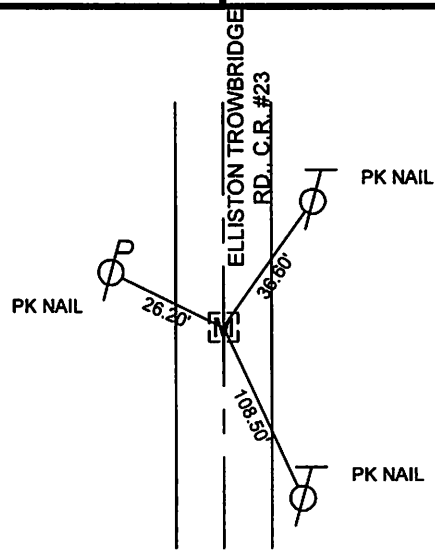

ADDITIONAL LONG TIE
C/L N. SIDE 24" DIA.
TREE E - 43.75'