

# OTTAWA COUNTY ENGINEERS OFFICE


REFERENCE NO. 32-7-14-F  
 EAST QUARTER POST SEC. 32  
 BENTON TWP.  
 SHEET 1 OF 1.

ROUTE: C-19 GRAYTOWN RD.  
 TOWNSHIP: BENTON  
 SECTION: 32  
 T 7 NR 14 E.

PERSONNEL:  
 M. WITTMAN, P.S.  
 J. ALLEN

NORTHING:  
 EASTING:  
 DATUM:

DATE / WEATHER / TEMP:  
 MARCH 26, 2012  
 SUNNY - NE  
 45° F

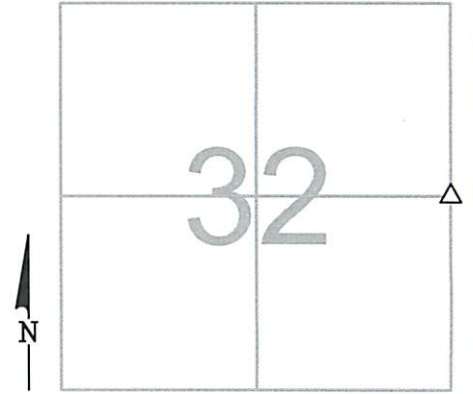

### MONUMENT INFORMATION

MONUMENT TYPE: 7½" X 11½" HARDHEAD STONE  
 ON SURFACE - BELOW: 1.88'  
 LEFT - CL PAV'T - RIGHT: 4.50'  
 FLAT KIDNEY SHAPED STONE W/ FAINT "X" IN CENTER  
 USED FAINT "X" IN CENTER OF STONE



### MISC. INFORMATION

MARCH 26, 2012

SET 1" SQUARE IRON PIN  
 IN MONUMENT BOX OVER  
 STONE

