

OTTAWA COUNTY ENGINEERS OFFICE

REFERENCE NO. 32-7-14-H
 SOUTH QUARTER POST SEC. 32
 BENTON TWP.
 SHEET 1 OF 1.

ROUTE: STATE ROUTE #163

TOWNSHIP: BENTON

SECTION: 32

T 7 NR 14 E.

PERSONNEL:

M. WITTMAN, P.S.
 J. ALLEN
 C. MILLER
 D. HOHMAN, P.S. - ODOT
 T. ROUSOS - ODOT


NORTHING:

EASTING:

DATE / WEATHER / TEMP:

MAY 2, 2013
 SUNNY - S,SW
 65° F

DATUM:

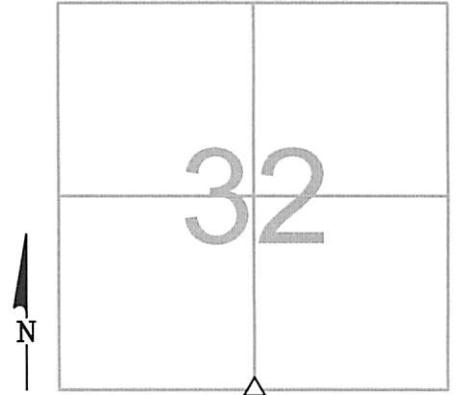

MONUMENT INFORMATION

MONUMENT TYPE: FD 7" X 6" LIMESTONE
 ON SURFACE - BELOW: 1.78'
 LEFT - CL PAV'T - RIGHT: 5.40'

STONE WAS BROKEN INTO 3 PIECES

USED FAINT "X" - SET DRILL HOLE IN CENTER OF "X"
 DRILL HOLE WAS 0.09' W AND 0.03' N OF SURFACE NAIL



MISC. INFORMATION

FD PK NAIL AND SHINER ON SURFACE, TIED W/ X-TIES AND DUG FOR STONE. FD PK NAIL AND SHINER 0.13' BELOW SURFACE, 0.02' S AND 0.02' W OF SURFACE NAIL. FD MINE SPIKE AND WASHER 0.24' BELOW SURFACE, 0.06' S AND 0.07' W OF SURFACE NAIL, FD 2" X 2" WOOD HUB 0.71' BELOW SURFACE, 0.06' N AND 0.11' W OF SURFACE NAIL. STONE WITNESSED BY GLEN KLAUSTERMEYER. 8-23-13: SET 1" Ø X 17" LONG IRON PIN IN FLOODED MASONRY SAND IN 6" Ø PVC IN MONUMENT BOX WITH ODOT AND SHELLY CO. ASSISTANCE.

AUGUST 23, 2013

SET 1" Ø IRON PIN
 IN MONUMENT BOX
 OVER STONE

