

OTTAWA COUNTY ENGINEERS OFFICE

REFERENCE NO. 32-8-14-D
 WEST QUARTER POST SEC. 32
 BENTON TWP.
 SHEET 1 OF 1.

ROUTE: C-208 ELLISTON-TROWBRIDGE RD.

TOWNSHIP: BENTON

SECTION: 32


T 8 NR 14 E.

PERSONNEL:
 M. WITTMAN, P.S.
 J. ALLEN

NORTHING:

EASTING:

DATUM:

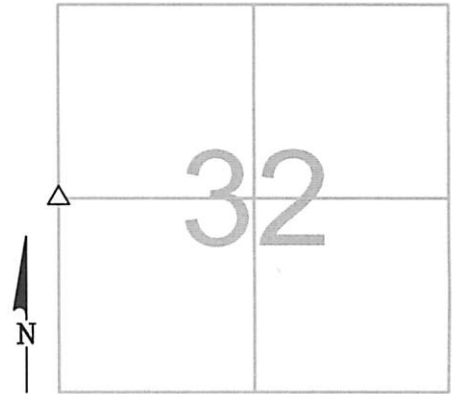

DATE / WEATHER / TEMP:

JUNE 30, 2014
 PTLY SUNNY, S
 82° F

MONUMENT INFORMATION

MONUMENT TYPE: FD RECTANGULAR LIMESTONE
 ON SURFACE - BELOW: 1.58'
 LEFT - CL PAV'T - RIGHT: 4.85'

STONE IS 8" X 4" X 8" - LEANING SW WITH SE CORNER
 BROKEN OFF.

USED CENTER OF STONE.



MISC. INFORMATION

FD RR SPIKE 0.12' BELOW SURFACE, TIED W/ X-TIES
 AND DUG FOR STONE. RR SPK WAS 0.22' EAST AND
 0.15' NORTH OF CENTER OF STONE.

JUNE 30, 2014

SET 1" SQUARE IRON PIN
 IN MONUMENT BOX OVER
 STONE

