

OTTAWA COUNTY ENGINEERS OFFICE

REFERENCE NO. 33-7-14-B
NORTH QUARTER POST SEC. 33
BENTON TWP.
SHEET 1 OF 1.

PERSONNEL:
M. WITTMAN, P.S.
J. ALLEN

DATE / WEATHER / TEMP:
AUGUST 5, 2013
PARTLY SUNNY - S
68° F

ROUTE: T-78 SONDERGELD RD.

TOWNSHIP: BENTON


SECTION: 33

T 7 NR 14 E.

NORTHING:

EASTING:

DATUM:

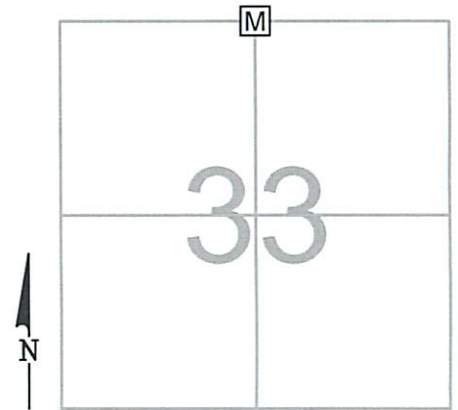

MONUMENT INFORMATION

MONUMENT TYPE: SET 1" SQ. IRON PIN IN MON. BOX
ON SURFACE - BELOW:
LEFT - CL PAV'T - RIGHT: 9.00'



MISC. INFORMATION

SET BY PROPORTIONATE MEASUREMENT BASED
ON SONDERGELD ROAD SURVEY DATED 9-2-1942 IN
BENTON BOOK 19 PAGE 71.

AUGUST 5, 2013

SET 1" SQUARE IRON PIN
IN MONUMENT BOX

