

OTTAWA COUNTY ENGINEERS OFFICE

REFERENCE NO. 33-7-14-D
 WEST QUARTER POST SEC. 33
 BENTON TWP.
 SHEET 1 OF 1.

ROUTE: C-19 GRAYTOWN RD.
 TOWNSHIP: BENTON
 SECTION: 33
 T 7 NR 14 E.


PERSONNEL:
 M. WITTMAN, P.S.
 J. ALLEN

NORTHING:

EASTING:

DATUM:

DATE / WEATHER / TEMP:
 MARCH 26, 2012
 SUNNY - NE
 45° F

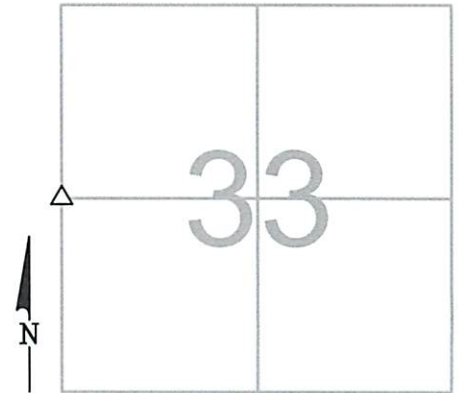

MONUMENT INFORMATION

MONUMENT TYPE: 7½" X 11½" HARDHEAD STONE
 ON SURFACE - BELOW: 1.88'
 LEFT - CL PAV'T - RIGHT: 4.50'

FLAT KIDNEY SHAPED STONE W/ FAINT "X" IN CENTER
 USED FAINT "X" IN CENTER OF STONE



MISC. INFORMATION

MARCH 26, 2012

SET 1" SQUARE IRON PIN
 IN MONUMENT BOX OVER
 STONE

