

# OTTAWA COUNTY ENGINEERS OFFICE

REFERENCE NO. 33-7-14-I  
 SE CORNER POST SEC. 33  
 BENTON TWP.  
 SHEET 1 OF 1.

ROUTE: STATE ROUTE #163  
 @ T-21 STANGE RD.

TOWNSHIP: BENTON

SECTION: 33

T 7 NR 14 E.


NORTHING:

EASTING:

DATUM:

PERSONNEL:  
 M. WITTMAN, P.S.  
 J. ALLEN  
 M. BROUGH  
 C. MILLER

DATE / WEATHER / TEMP:  
 APRIL 30, 2013  
 SUNNY - S, SW  
 72° F

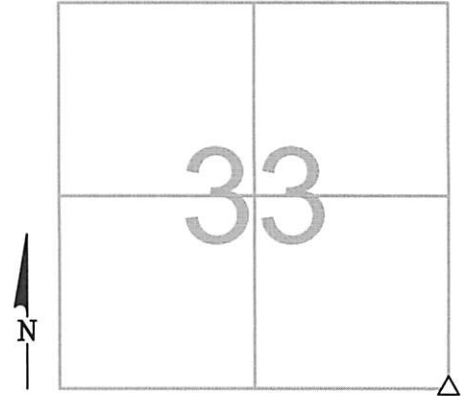

### MONUMENT INFORMATION

MONUMENT TYPE: FD 4" X 9" HARDHEAD STONE  
 ON SURFACE - BELOW: 1.92'  
LEFT - CL PAV'T - RIGHT: 6.84' (SR 163) 2.0' L (T-21)

STONE HAD NO DISTINGUISHING MARKS, SET AND  
 USED SHALLOW DH IN CENTER OF STONE.



### MISC. INFORMATION

FD MINE SPIKE AND WASHER 0.50' BELOW SURFACE, TIED W/ X-TIES  
 AND DUG FOR STONE. FD NAIL AND SHINER 0.86' BELOW SURFACE  
 0.04' W AND 0.05' S OF SURFACE NAIL. FD 1" X 2" WOOD HUB 0.96'  
 BELOW SURFACE 0.19' E AND 0.21' S OF SURFACE NAIL. DH USED  
 ON STONE WAS 0.07' E AND 0.27' S OF SURFACE NAIL. STONE WAS  
 WITNESSED BY JAMES WITTMAN.

8-22-13; SET 1" Ø X 19" LONG IRON PIN IN FLOODED MASONRY SAND  
 IN 6" Ø PVC IN MONUMENT BOX WITH ODOT AND SHELLY CO.  
 ASSISTANCE.

AUGUST 22, 2013

SET 1" Ø IRON PIN  
 IN MONUMENT BOX  
 OVER STONE

