

# OTTAWA COUNTY ENGINEERS OFFICE

REFERENCE NO. 33-8-14-E  
CENTER POST SECTION 33  
BENTON TWP.  
SHEET 1 OF 1.

ROUTE: T-76 KRAUSE RD.

TOWNSHIP: BENTON

SECTION: 33


T 8 NR 14 E.

PERSONNEL:  
M. WITTMAN, P.S.  
J. ALLEN

NORTHING:

EASTING:

DATUM:

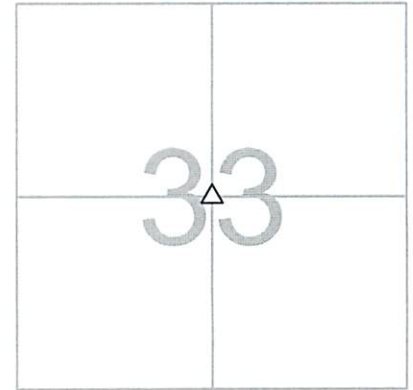

DATE / WEATHER / TEMP:  
AUGUST 18, 2014  
SUNNY, SE  
78° F

## MONUMENT INFORMATION

MONUMENT TYPE: FD 6" X 3-1/2" POINTED LIMESTONE  
ON SURFACE - BELOW: 0.94'  
LEFT - CL PAV'T - RIGHT: 4.0'

STONE HAD HIGH RIDGE RUNNING W-E, USED  
CENTER OF HIGH RIDGE.



## MISC. INFORMATION

FD. 1" SQUARE TOP IRON PIN 0.07' BELOW SURFACE,  
TIED W/ X-TIES AND DUG FOR STONE.

BOLT WAS 0.12' EAST AND 0.05' SOUTH OF POINT  
USED ON STONE.

AUGUST 18, 2014

SET 1" SQUARE IRON PIN  
IN MONUMENT BOX OVER  
STONE

