

OTTAWA COUNTY ENGINEERS OFFICE

REFERENCE NO. 33-8-14-F
 EAST QUARTER POST SEC. 33
 BENTON TWP.
SHEET 1 OF 1.

ROUTE: T-21 STANGE RD.
 @ T-76 KRAUSE RD.

TOWNSHIP: BENTON

SECTION: 33

T 8 N R 14 E.


PERSONNEL:
 M. WITTMAN, P.S.
 J. ALLEN

NORTHING:

EASTING:

DATUM:


DATE / WEATHER / TEMP:
 AUGUST 18, 2014
 OVERCAST, SE
 75° F

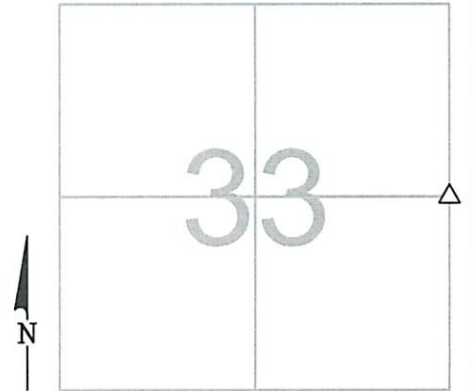

MONUMENT INFORMATION

MONUMENT TYPE: FD. RR SPK
 ON SURFACE - BELOW: 0.25'
LEFT - CL PAV'T - RIGHT: 10.30'

 SET 1" SQUARE IRON PIN IN MONUMENT BOX.

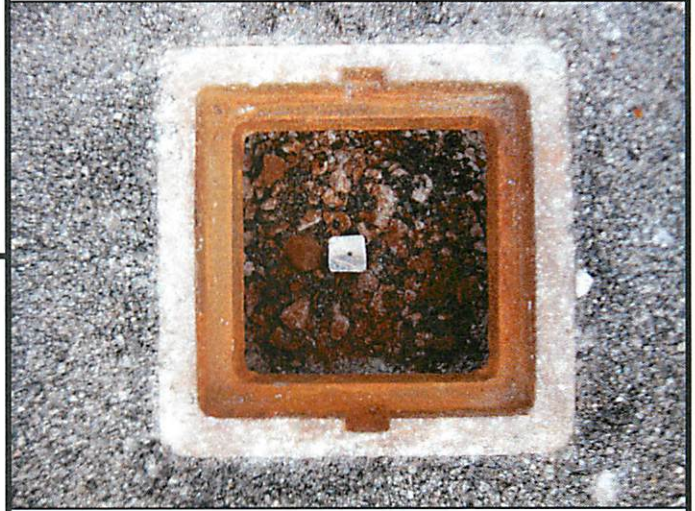

MISC. INFORMATION

FD RR SPK 0.25' BELOW SURFACE, TIED W/ X-TIES
 AND DUG FOR PIN AND/OR STONE OF RECORD.
 DID NOT FIND EITHER PIN OR STONE. CHECKED
 DISTANCE SOUTH AND WEST TO 8-24-1898 C.E.
 DEWITT SURVEY AND ACCEPTED LOCATION OF FD
 RR SPK AS POINT.

AUGUST 18, 2014

SET 1" SQUARE IRON PIN
 IN MONUMENT BOX

