

OTTAWA COUNTY ENGINEERS OFFICE

REFERENCE NO. 34-7-14-D
 WEST QUARTER POST SEC. 34
 BENTON TWP.
 SHEET 1 OF 1.

ROUTE: T-21 STANGE RD.
 @ T-79 KOLB RD.

TOWNSHIP: BENTON

SECTION: 34

T 7 NR 14 E.


NORTHING:

EASTING:

DATUM:

PERSONNEL:
 M. WITTMAN, P.S.
 J. ALLEN

DATE / WEATHER / TEMP:
 MAY 5, 2016
 SUNNY - N
 61° F

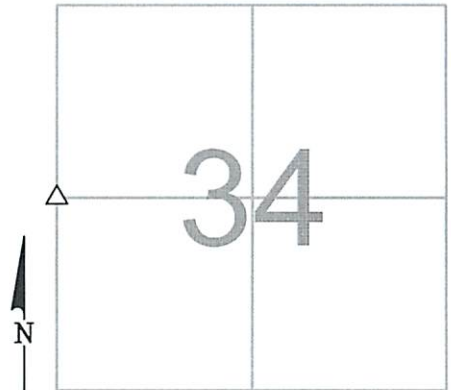

MONUMENT INFORMATION

MONUMENT TYPE: FD. 10"x8" HARDHEAD STONE
 ON SURFACE - BELOW: 1.07'
LEFT - CL PAV'T - RIGHT: 5.00'

TRIANGULAR STONE WITH SLIGHT DEPRESSION IN
 CENTER. USED CENTER OF STONE.



MISC. INFORMATION

5-3-16 FD. RR SPIKE 0.10' BELOW SURFACE, TIED W/
 X-TIES AND DUG FOR STONE. DID NOT FIND STONE.
 TOOK GPS SHOTS AND CALCULATED LOCATION.
5-5-16 DUG AT CALCULATED LOCATION AND FOUND
 STONE.

RR SPIKE WAS 3.70' W AND 1.40' S OF CENTER OF
 STONE.

MAY 5, 2016

SET 1" SQUARE IRON PIN
 IN MONUMENT BOX OVER
 STONE

