

OTTAWA COUNTY ENGINEERS OFFICE

REFERENCE NO. 34-8-14-D
WEST QUARTER POST SEC. 34
BENTON TWP.
SHEET 1 OF 1.

ROUTE: T-21 STANGE RD.
@ T-76 KRAUSE RD.

TOWNSHIP: BENTON

SECTION: 34

T 8 NR 14 E.


PERSONNEL:
M. WITTMAN, P.S.
J. ALLEN

NORTHING:

EASTING:

DATE / WEATHER / TEMP:
AUGUST 18, 2014
OVERCAST, SE
75° F

DATUM:

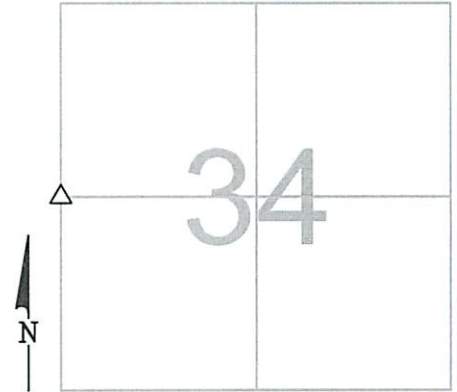

MONUMENT INFORMATION

MONUMENT TYPE: FD. RR SPK
ON SURFACE - BELOW: 0.25'
LEFT - CL PAV'T - RIGHT: 10.30'

SET 1" SQUARE IRON PIN IN MONUMENT BOX.



MISC. INFORMATION

FD RR SPK 0.25' BELOW SURFACE, TIED W/ X-TIES
AND DUG FOR PIN AND/OR STONE OF RECORD.
DID NOT FIND EITHER PIN OR STONE. CHECKED
DISTANCE SOUTH AND WEST TO 8-24-1898 C.E.
DEWITT SURVEY AND ACCEPTED LOCATION OF FD
RR SPK AS POINT.

AUGUST 18, 2014

SET 1" SQUARE IRON PIN
IN MONUMENT BOX

KRAUSE RD., T.R. #76

