

# OTTAWA COUNTY ENGINEERS OFFICE

REFERENCE NO. 35-7-14-B  
NORTH QUARTER POST SEC. 35  
BENTON TWP.  
SHEET 1 OF 1.

ROUTE: MAIN ST. @ THIRD ST.  
(VILLAGE OF ROCKY RIDGE)

TOWNSHIP: BENTON

SECTION: 35

T 7 NR 14 E.


NORTHING:

EASTING:

DATUM:

PERSONNEL:  
M. WITTMAN, P.S.  
J. ALLEN

DATE / WEATHER / TEMP:  
JULY 31, 2014  
SUNNY, N-NW  
77° F

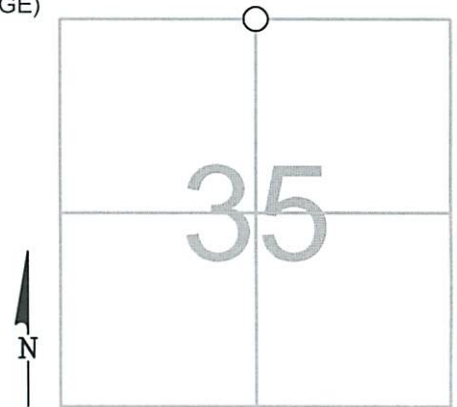

## MONUMENT INFORMATION

MONUMENT TYPE: FD 3/4" Ø IRON PIN  
ON SURFACE - BELOW: 0.45'  
LEFT - CL PAV'T - RIGHT:  
  
SET DH IN CENTER OF PIN.



## MISC. INFORMATION

IRON PIN SET BY C.A. STEVENSON IN AUGUST 1956  
PER SURVEY DATED AUGUST 1956.

JULY 31, 2014

SET MONUMENT BOX OVER PIN

