

OTTAWA COUNTY ENGINEERS OFFICE

REFERENCE NO. 35-7-14-C
NE CORNER SECTION 35
BENTON TWP.
SHEET 1 OF 1.

ROUTE: T-22 LICKERT-HARDER RD.
@ THIRD STREET

TOWNSHIP: BENTON

SECTION: 35

T 7 NR 14 E.

NORTHING:

EASTING:

DATUM:

PERSONNEL:
M. WITTMAN, P.S.
J. ALLEN

DATE / WEATHER / TEMP:
SEPTEMBER 15, 2008
OVERCAST
63° F




MONUMENT INFORMATION

MONUMENT TYPE: FD POINTED LIMESTONE
ON SURFACE - BELOW: 2.37'
LEFT - CL PAV'T - RIGHT: 4.20'

TRIANGULAR STONE: 4- $\frac{1}{2}$ " x 6"

USED POINT

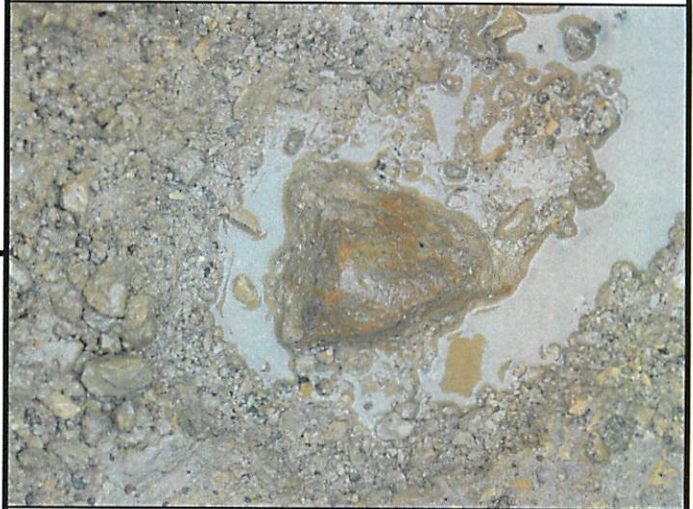

MISC. INFORMATION

FD. RR SPIKE ON SURFACE THAT MATCHED THE ONLY EXISTING RECORD TIE. TIED RR SPIKE DOWN WITH X-TIES, DUG, BUT NOTHING FOUND. WORKED DIG NORTHWEST ALONG ARC AND FOUND STONE. RR SPIKE ON SURFACE WAS 1.13' S AND 2.69' E OF POINT OF STONE.

SEPTEMBER 15, 2008

SET 1" SQUARE IRON PIN
IN MONUMENT BOX OVER
STONE

