

OTTAWA COUNTY ENGINEERS OFFICE

REFERENCE NO. 35-7-14-E
 CENTER POST SECTION 35
 BENTON TWP.
 SHEET 1 OF 1.

ROUTE: C-75 ROCKY RIDGE RD.
 @ T-79 KOLB RD.

TOWNSHIP: BENTON

SECTION: 35

T 7 NR 14 E.


NORTHING:

EASTING:

DATUM:

PERSONNEL:
 M. WITTMAN, P.S.
 J. ALLEN

DATE / WEATHER / TEMP:
 AUGUST 1, 2014
 SUNNY, W
 74° F

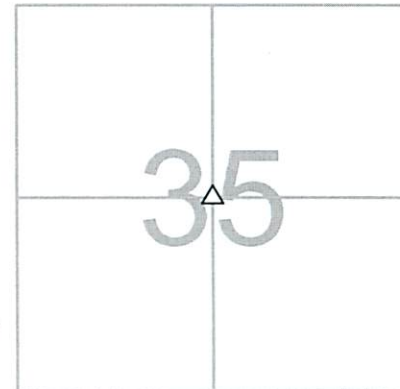

MONUMENT INFORMATION

MONUMENT TYPE: FD HARDHEAD STONE
 ON SURFACE - BELOW: 1.65'
LEFT - CL PAV'T - RIGHT: 1.00'

8" X 9" RECTANGULAR HARDHEAD WITH DH.
 USED DH.



MISC. INFORMATION

FD. LANDSCAPE NAIL 0.52' BELOW SURFACE, TIED
 W/ GPS AND DUG FOR STONE.

LANDSCAPE NAIL WAS 0.08' WEST AND 0.8' NORTH
 OF DRILL HOLE IN STONE.

AUGUST 1, 2014

SET 1" SQUARE IRON PIN
 IN MONUMENT BOX OVER
 STONE

