

OTTAWA COUNTY ENGINEERS OFFICE

REFERENCE NO. 35-7-14-G
 SW CORNER POST SEC. 35
 BENTON TWP.
SHEET 1 OF 1.

ROUTE: STATE ROUTE #163
 @ STATE ROUTE #590

TOWNSHIP: BENTON


SECTION: 35

T 7 **NR** 14 **E.**

NORTHING:

EASTING:

DATUM:

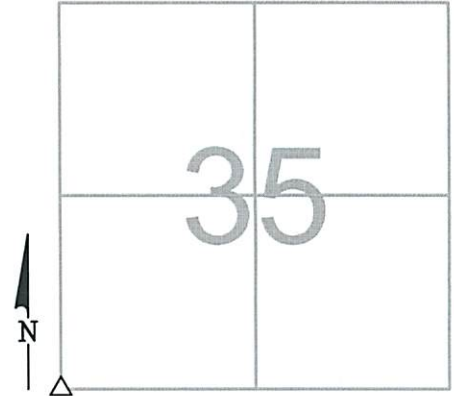

PERSONNEL:

M. WITTMAN, P.S.
 J. ALLEN
 S. CODER, P.S. - ODOT
 J. RHODES - ODOT
 SHELLY CO.

DATE / WEATHER / TEMP:

AUGUST 22, 2013
 OVERCAST - W,SW
 70° F

MONUMENT INFORMATION

MONUMENT TYPE: FD 5" X 6" LIMESTONE
 ON SURFACE - BELOW: 2.09'
 LEFT - CL PAV'T - RIGHT:

 POINTED STONE WITH SMALL DRILL HOLE IN PIPE
 MARK ON POINTED SE CORNER - USED DRILL HOLE



MISC. INFORMATION

FD 3/4" Ø BY 19" LONG IRON PIPE 0.51' BELOW SURFACE.
 IRON PIPE PER ODOT RECORDS. REMOVED IRON PIPE
 AND DUG FOR STONE.

 SET 1" Ø X 19" LONG IRON PIN IN FLOODED MASONRY
 SAND IN 6" Ø PVC IN MONUMENT BOX OVER STONE WITH
 ODOT AND SHELLY CO. ASSISTANCE

AUGUST 22, 2013

SET 1" Ø IRON PIN
 IN MONUMENT BOX
 OVER STONE

