

OTTAWA COUNTY ENGINEERS OFFICE

REFERENCE NO. 36-7-14-B
NORTH QUARTER POST SEC. 36
BENTON TWP.
SHEET 1 OF 1.

ROUTE: T-98 SCHILLER RD.

TOWNSHIP: BENTON

SECTION: 36

T 7 NR 14 E.

PERSONNEL:

M. WITTMAN, P.S.
J. ALLEN
E. KOCH
C. MILLER


NORTHING:

EASTING:

DATE / WEATHER / TEMP:

JULY 10, 2009
SUNNY
72° F

DATUM:

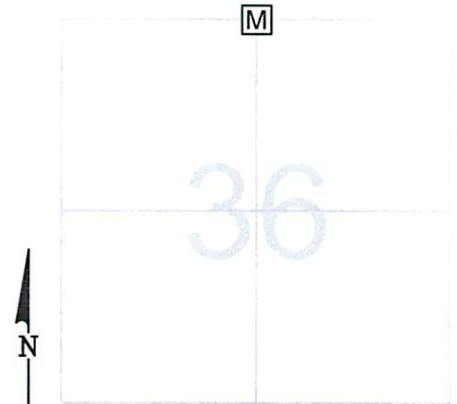

MONUMENT INFORMATION

MONUMENT TYPE: SET 1" SQ. IRON PIN IN MON. BOX
ON SURFACE - BELOW:
LEFT - CL PAV'T - RIGHT: 1.00'



MISC. INFORMATION

FD. RR SPIKE ON SURFACE PER PRIOR SURVEYS OF RECORD.
TIED RAILROAD SPIKE W/ CROSS TIES AND DUG FOR STONE -
STONE NOT FOUND. TOOK SHOTS AND DUG FOR STONE WEST
AND SOUTH OF RAILROAD SPIKE - STONE NOT FOUND. SET
POINT PER FIELD NOTE S BY C.E. DEWITT DATED APRIL 1895,
USING ANGLE AND DISTANCE FORM SOUTHEAST CORNER
SECTION 25. RAILROAD SPIKE WAS 4.25' NORTHAND 1.31'
EAST.

JULY 10, 2009

SET 1" SQUARE IRON PIN
IN MONUMENT BOX

