

OTTAWA COUNTY ENGINEERS OFFICE

REFERENCE NO. 36-7-14-C
NE CORNER POST SECTION 36
BENTON TWP.
SHEET 1 OF 1.

ROUTE: C-23 BENTON-CARROLL RD.
@ T-98 SCHILLER RD.

TOWNSHIP: BENTON

SECTION: 36

T 7 NR 14 E.


NORTHING:

EASTING:

DATUM:

PERSONNEL:
M. WITTMAN, P.S.
J. ALLEN
K. SMITH
S. ULLRICH

DATE / WEATHER / TEMP:
JULY 11, 2007
SUNNY W-NW
80° F

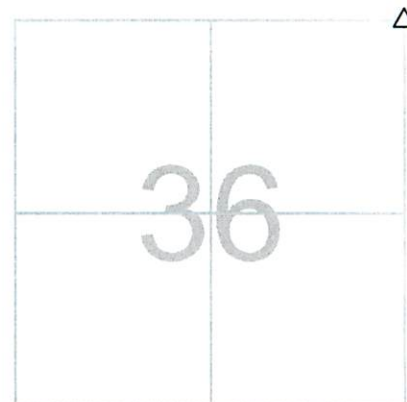

MONUMENT INFORMATION

MONUMENT TYPE: FD STONE W/ NOTCH
ON SURFACE - BELOW: 1.80'
LEFT - CL PAV'T - RIGHT: 4.50'
SANDSTONE (BROKEN) USED CENTER OF
NOTCH, PLACED DRILL HOLE.
ALSO FOUND 2"X2" WOOD STAKE EAST OF
STONE.



MISC. INFORMATION

JULY 11, 2007

SET 1" SQUARE IRON PIN
IN MONUMENT BOX OVER
STONE

