

OTTAWA COUNTY ENGINEERS OFFICE

REFERENCE NO. 36-7-14-E
CENTER POST POST SEC. 36
BENTON TWP.
SHEET 1 OF 1.

ROUTE: T-79 KOLB RD.

TOWNSHIP: BENTON

SECTION: 36

T 7 NR 14 E.


PERSONNEL:
M. WITTMAN, P.S.
J. ALLEN

NORTHING:

EASTING:

DATUM:

DATE / WEATHER / TEMP:
AUGUST 3, 2012
SUNNY
82° F

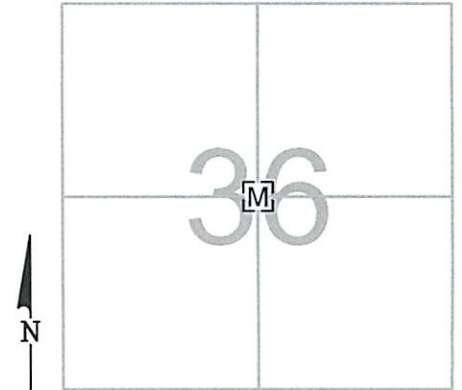

MONUMENT INFORMATION

MONUMENT TYPE: FD 1" SQ IRON PIN IN MON BOX
ON SURFACE - BELOW:
LEFT - CL PAV'T - RIGHT: 1.00'



MISC. INFORMATION

