

# OTTAWA COUNTY ENGINEERS OFFICE

**REFERENCE NO.** 36-8-14-G  
 SW CORNER POST SECTION 36  
 BENTON TWP.  
**SHEET** 1 OF 1.

**ROUTE:** T-22 LICKERT- HARDER RD.  
 @ S-2 STATE ROUTE 2

**TOWNSHIP:** BENTON


**SECTION:** 36

**T** 8 **NR** 14 **E.**

**NORTHING:**

**EASTING:**

**DATUM:**

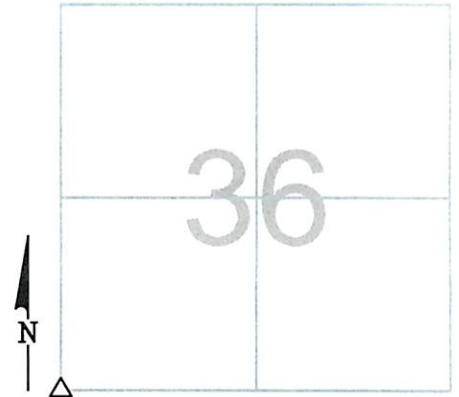

**PERSONNEL:**  
 M. WITTMAN, P.S.  
 J. ALLEN  
 K. SMITH

**DATE / WEATHER / TEMP:**  
 AUGUST 27, 2007  
 SUNNY - E  
 80° F

### MONUMENT INFORMATION


MONUMENT TYPE: FD STONE  
 ON SURFACE - BELOW: 2' +/-  
 LEFT - CL PAV'T - RIGHT:

FD. LIMESTONE 5" X 10" X 10.5" WITH REMNANTS  
 OF CLAY TILE IN VICINITY.



### MISC. INFORMATION

STONE WAS LOCATED BY MILLER BROS. CONSTRUCTION  
 WHILE EXCAVATING FOR ODOT PROJECT 07-0150. JAN  
 MATERNI - ODOT PROJECT MANAGER STATED THAT THERE  
 WAS AN EXISTING IRON PIN IN A MONUMENT BOX PRIOR TO  
 CONSTRUCTION. ODOT SURVEY CREWS USED GPS TO TIE  
 DOWN LOCATION OF STONE. OTTAWA COUNTY CREW  
 VISITED SITE 8-27-07 TO VERIFY, PHOTOGRAPH AND TIE  
 DOWN.

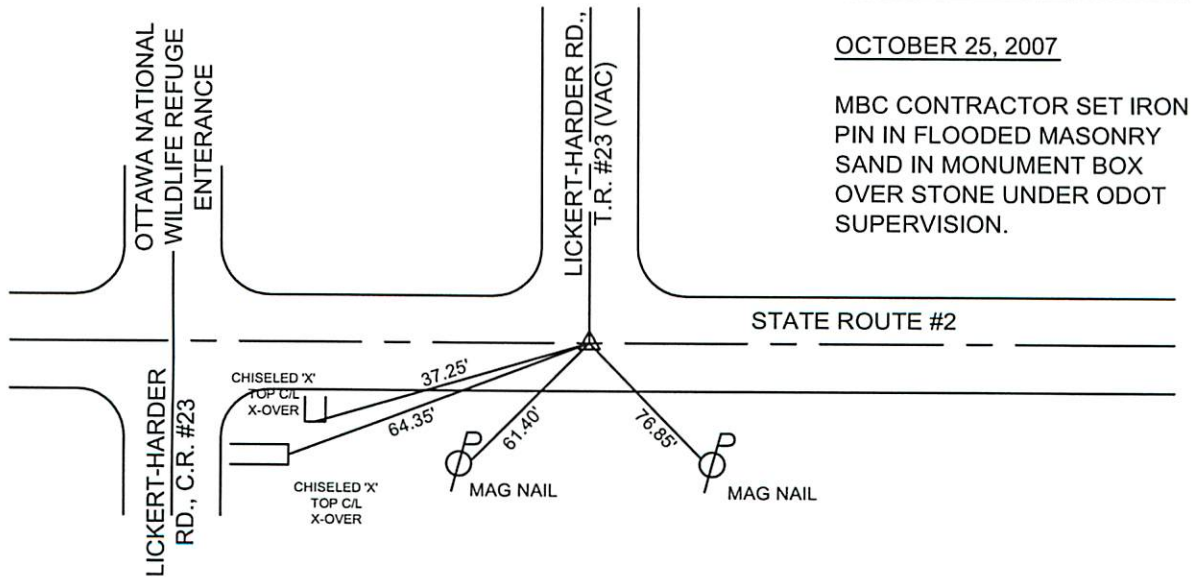

OCTOBER 25, 2007

MBC CONTRACTOR SET IRON  
 PIN IN FLOODED MASONRY  
 SAND IN MONUMENT BOX  
 OVER STONE UNDER ODOT  
 SUPERVISION.