

OTTAWA COUNTY ENGINEERS OFFICE

REFERENCE NO. 4-7-14-A
NW CORNER POST SEC. 4
BENTON TWP.
SHEET 1 OF 1.

PERSONNEL:
M. WITTMAN, P.S.
J. ALLEN

DATE / WEATHER / TEMP:
NOVEMBER 15, 2012
SUNNY
45° F

ROUTE: S-579 @ GRAYTOWN RD.

TOWNSHIP: BENTON


SECTION: 4

T 7 NR 14 E.

NORTHING:

EASTING:

DATUM:

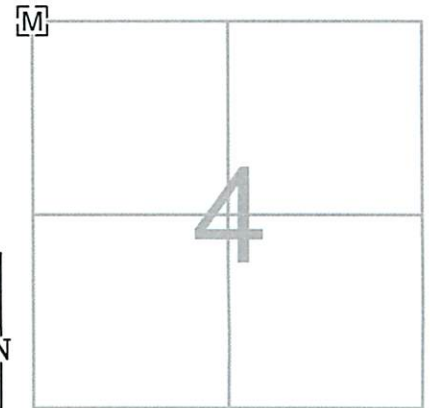

MONUMENT INFORMATION

MONUMENT TYPE: FD. 3/4" Ø IRON PIN IN MON BOX
ON SURFACE - BELOW:
LEFT - CL PAVT - RIGHT: 1.50'



MISC. INFORMATION

THIS IS A CLOSING CORNER.

