

# OTTAWA COUNTY ENGINEERS OFFICE

REFERENCE NO. 4-7-14-D  
WEST QUARTER POST SEC. 4  
BENTON TWP.  
SHEET 1 OF 1.

PERSONNEL:  
M. WITTMAN, P.S.  
J. ALLEN

DATE / WEATHER / TEMP:  
SEPTEMBER 16, 2008  
SUNNY W-NW  
70° F

ROUTE: C-19 GRAYTOWN RD.

TOWNSHIP: BENTON


SECTION: 4

T 7 NR 14 E.

NORTHING:

EASTING:

DATUM:

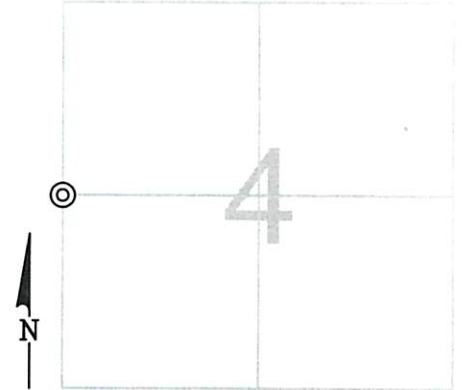

## MONUMENT INFORMATION

MONUMENT TYPE: FD. 1 1/4" O.D. IRON PIPE WITH  
HEX BOLT IN TOP  
ON SURFACE - BELOW: 0.30'  
LEFT - CL PAV'T - RIGHT: 10.5'



## MISC. INFORMATION

IRON PIPE IS IN WEST WHITE LINE OF  
PAVEMENT

SEPTEMBER 16, 2008

SET MONUMENT BOX OVER  
FD. PIPE

