

OTTAWA COUNTY ENGINEERS OFFICE

REFERENCE NO. 4-7-14-G
SW CORNER SECTION 4
BENTON TWP.
SHEET 1 OF 1.

ROUTE: C-19 GRAYTOWN RD.
@ T-68 WALBRIDGE E. RD.

TOWNSHIP: BENTON

SECTION: 4

T 7 NR 14 E.


NORTHING:

EASTING:

DATUM:

PERSONNEL:
M. WITTMAN, P.S.
J. ALLEN

DATE / WEATHER / TEMP:
SEPTEMBER 18, 2008
SUNNY NE
72° F

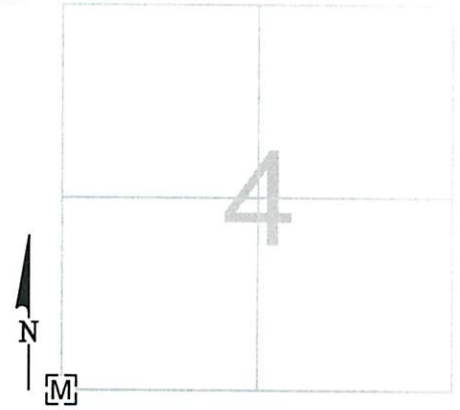

MONUMENT INFORMATION

MONUMENT TYPE: FD. $\frac{3}{4}$ " SQ. EXTENSION IRON
PIN PATCHED IN A ROUND MONUMENT BOX
ON SURFACE - BELOW: 0.43'
LEFT - CL PAV'T - RIGHT: 4.90'



MISC. INFORMATION

SEPTEMBER 18, 2008

SET MONUMENT BOX OVER
EXISTING PIN IN ROUND
MONUMENT BOX

