

OTTAWA COUNTY ENGINEERS OFFICE

REFERENCE NO. 5-7-14-C
NE CORNER POST SEC. 5
BENTON TWP.
SHEET 1 OF 1.

ROUTE: S-579 @ GRAYTOWN RD.

TOWNSHIP: BENTON

SECTION: 5

T 7 NR 14 E.

PERSONNEL:

M. WITTMAN, P.S.
J. ALLEN


NORTHING:

EASTING:

DATUM:

DATE / WEATHER / TEMP:

NOVEMBER 15, 2012
SUNNY
45° F

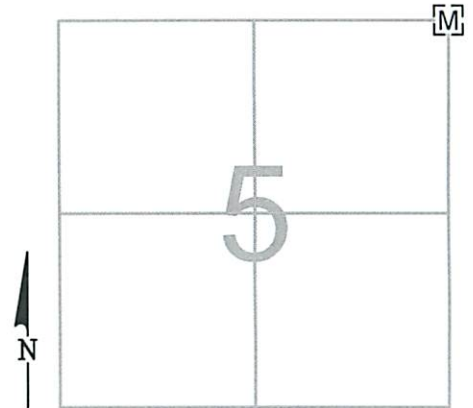

MONUMENT INFORMATION

MONUMENT TYPE: FD. 3/4" Ø IRON PIN IN MON BOX
ON SURFACE - BELOW:
LEFT - CL PAV'T - RIGHT: 1.50'



MISC. INFORMATION

THIS IS A CLOSING CORNER.

