

# OTTAWA COUNTY ENGINEERS OFFICE

REFERENCE NO. 5-7-14-D  
WEST QUARTER POST SEC 5  
BENTON TWP.

SHEET 1 OF 1.

**PERSONNEL:**

M. WITTMAN, P.S.  
J. ALLEN  
J. LAUBACHER

**DATE / WEATHER / TEMP:**

JUNE 25, 2011  
SUNNY N  
86° F

ROUTE: C-208 ELLISTON TROWBRIDGE RD

TOWNSHIP: BENTON


SECTION: 5

T 7 NR 15 E.

NORTHING:

EASTING:

DATUM:

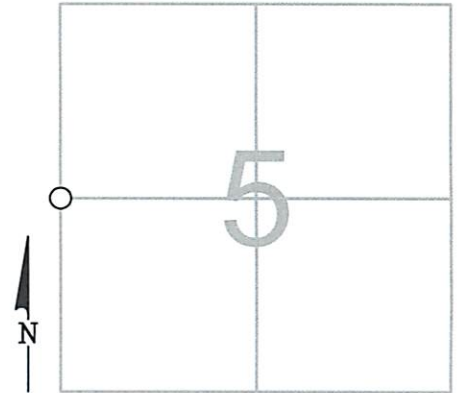


MONUMENT INFORMATION

MONUMENT TYPE: FD RAILROAD SPIRKE  
ON SURFACE - BELOW: 0.29'  
LEFT - CL PAV'T - RIGHT: 0.90'

MISC. INFORMATION

FD RR SPK 0.29' BELOW SURFACE  
TIED W/ X-TIES & DUG FOR STONE  
DUG TO CLAY- DID NOT LOCATE STONE  
SET 1" SQ. IRON PIN WHERE RR SPK WAS FOUND

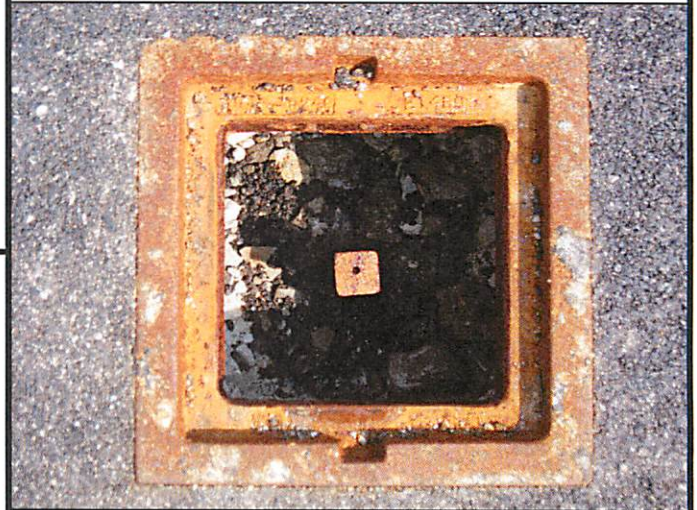

JUNE 25, 2011

SET 1" SQUARE IRON PIN  
IN MONUMENT BOX

