

OTTAWA COUNTY ENGINEERS OFFICE

REFERENCE NO. 5-7-14-G
 SW CORNER POST SEC 5
 BENTON TWP.
SHEET 1 OF 1.

ROUTE: C-208 ELLISTON TROWBRIDGE RD
 @ T-68 WALBRIDGE EAST RD

TOWNSHIP: BENTON


SECTION: 5

T 7 **NR** 14 **E.**

NORTHING:

EASTING:

DATUM:

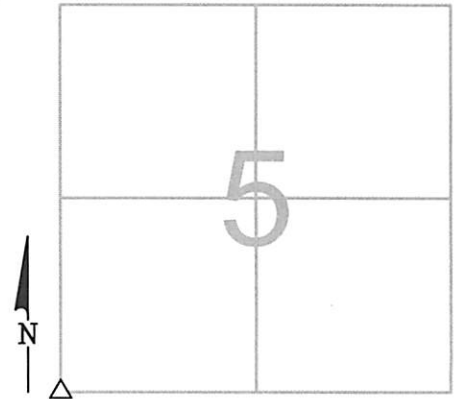

PERSONNEL:
 M. WITTMAN, P.S.
 J. ALLEN
 J. LAUBACHER

DATE / WEATHER / TEMP:
 JUNE 25, 2011
 OVERCAST NW
 83° F

MONUMENT INFORMATION

MONUMENT TYPE: FD 9" X 7½" LIMESTONE
 ON SURFACE - BELOW: 0.83'
LEFT - CL PAV'T - RIGHT: 1.25'



MISC. INFORMATION

FD PK NAIL 0.37' BELOW SURFACE
 TIED W/ X-TIES & DUG FOR STONE
 FD STONE WAS POINTED & OUTER LAYER ON
 SOUTH SIDE WAS SPLINTERED
 PK APPEARED TO BE TIED TO
 (GEOGRAPHIC) CENTER OF STONE
 REMOVED SPLINTERED AREA OF STONE
 PK WAS 0.04' W. OF CENTER OF STONE

JUNE 25, 2011

SET 1" SQUARE IRON PIN
 IN MONUMENT BOX OVER
 STONE

