

OTTAWA COUNTY ENGINEERS OFFICE

REFERENCE NO. 7-7-14-B
 NORTH QUARTER POST SEC 7
 BENTON TWP.
SHEET 1 OF 1.

ROUTE: T-68 WALBRIDGE EAST RD

TOWNSHIP: BENTON


SECTION: 7

T 7 **N** **R** 14 **E.**

NORTHING:

EASTING:

DATUM:

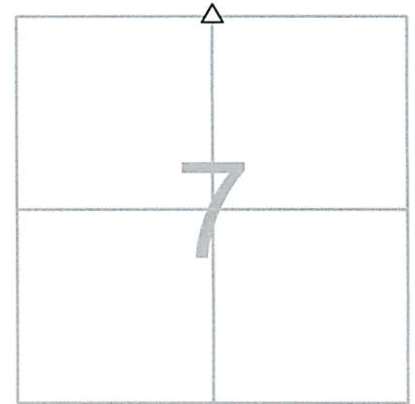

PERSONNEL:
 M. WITTMAN, P.S.
 J. ALLEN

DATE / WEATHER / TEMP:
 JUNE 16, 2011
 SUNNY SW
 76° F

MONUMENT INFORMATION

MONUMENT TYPE: FD FLAT LIMESTONE - 11"X6"X5"
 ON SURFACE - BELOW: 1.08'
 LEFT - CL PAV'T - RIGHT: 3.20'



MISC. INFORMATION

FD RR SPK ON SURFACE TIED W/ X-TIES & DUG
 FOR STONE RR SPK WAS 0.11' S & 0.09' W OF
 CENTER OF STONE
 USED CENTER OF STONE
 TOP HALF OF WEST TIP OF STONE WAS BROKEN
 OFF BOTTOM INTACT

JUNE 16, 2011

SET 1" SQUARE IRON PIN
 IN MONUMENT BOX OVER
 STONE

