

# OTTAWA COUNTY ENGINEERS OFFICE

**REFERENCE NO.** 7-7-14-F  
 EAST QUARTER POST SEC 7  
 BENTON TWP.  
**SHEET** 1 OF 1.

**ROUTE:** C-208 ELLISTON TROWBRIDGE RD  
 @ T-39 HAUSENCOMB RD

**TOWNSHIP:** BENTON


**SECTION:** 7

**T** 6 **NR** 14 **E.**

**NORTHING:**

**EASTING:**

**DATUM:**

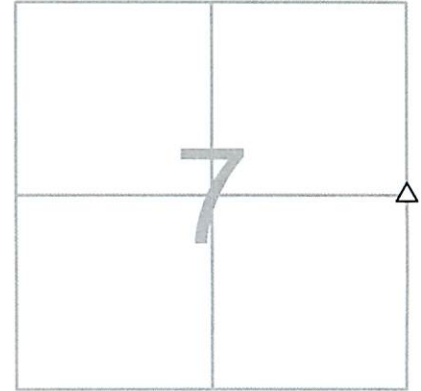

**PERSONNEL:**  
 M. WITTMAN, P.S.  
 J. ALLEN  
 J. LAUBACHER

**DATE / WEATHER / TEMP:**  
 JULY 19, 2011  
 SUNNY N-NE  
 90° F

### MONUMENT INFORMATION

MONUMENT TYPE: FD 10" X 6 1/2" STONE  
 ON SURFACE - BELOW: 1.65'  
LEFT - CL PAV'T - RIGHT: 1.30'  
 FOOTBALL SHAPED STONE



### MISC. INFORMATION

FD RR SPK 0.40' BELOW SURFACE  
 TIED W/ X-TIES & DUG FOR STONE  
 FD 1" X 1" WOOD HUB 0.66' BELOW SURFACE  
 0.05' S OF RR SPK  
 RR SPK WAS 0.06' W & 0.14' N OF CENTER OF  
 STONE  
 USED CENTER OF STONE

JULY 19, 2011

SET 1" SQUARE IRON PIN  
 IN MONUMENT BOX OVER  
 STONE

