

OTTAWA COUNTY ENGINEERS OFFICE

REFERENCE NO. 7-7-14-G
 SW CORNER POST SEC. 7
 BENTON TWP.
 SHEET 1 OF 1.

ROUTE: C-213 NISSEN RD.
 @ T-67 TROWBRIDGE RD.

TOWNSHIP: BENTON

SECTION: 7

T 7 NR 14 E.


PERSONNEL:
 M. WITTMAN, P.S.
 J. ALLEN

NORTHING:

EASTING:

DATE / WEATHER / TEMP:
 JULY 10, 2015
 PTLY SUNNY - SE
 72° F

DATUM:

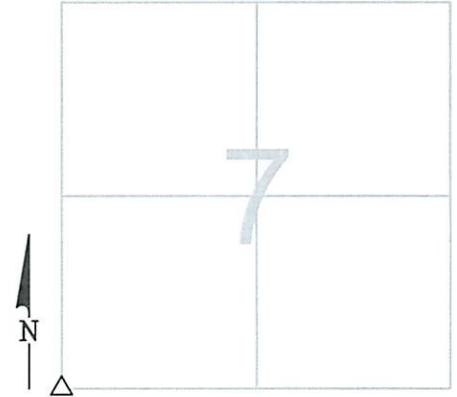

MONUMENT INFORMATION

MONUMENT TYPE: FD. 4"x10" POINTED LIMESTONE
 ON SURFACE - BELOW: 1.76'
LEFT - CL PAV'T - RIGHT: 4.85'
 USED HIGH POINT ON STONE.



MISC. INFORMATION

FD PK NAIL 0.30' BELOW SURFACE, TIED W/ X-TIES
 AND DUG FOR STONE. FD SCATTERED RR SPKS AND
 A WOOD STAKE ON NORTH EDGE OF STONE.
 SURFACE PK NAIL WAS ONLINE NORTH AND SOUTH
 AND 0.02' WEST OF HIGH POINT OF STONE.

THIS IS A CLOSING CORNER.

JULY 10, 2015

SET 1" SQUARE IRON PIN
 IN MONUMENT BOX OVER
 STONE

