

# OTTAWA COUNTY ENGINEERS OFFICE

**REFERENCE NO.** 8-7-14-A  
 NW CORNER POST SEC 8  
 BENTON TWP.  
**SHEET** 1 OF 1.

**ROUTE:** C-208 ELLISTON TROWBRIDGE RD  
 @ T-68 WALBRIDGE EAST RD

**TOWNSHIP:** BENTON


**SECTION:** 8

**T** 7 **NR** 14 **E.**

**NORTHING:**

**EASTING:**

**DATUM:**

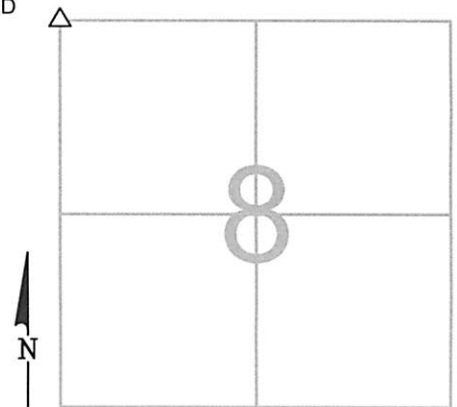

**PERSONNEL:**  
 M. WITTMAN, P.S.  
 J. ALLEN  
 J. LAUBACHER

**DATE / WEATHER / TEMP:**  
 JUNE 25, 2011  
 OVERCAST NW  
 83° F

MONUMENT INFORMATION

MONUMENT TYPE: FD 9" X 7½" LIMESTONE  
 ON SURFACE - BELOW: 0.83'  
LEFT - CL PAV'T - RIGHT: 1.25'



MISC. INFORMATION

FD PK NAIL 0.37' BELOW SURFACE  
 TIED W/ X-TIES & DUG FOR STONE  
 FD STONE WAS POINTED & OUTER LAYER ON  
 SOUTH SIDE WAS SPLINTERED  
 PK APPEARED TO BE TIED TO  
 (GEOGRAPHIC) CENTER OF STONE  
 REMOVED SPLINTERED AREA OF STONE  
 PK WAS 0.04' W. OF CENTER OF STONE

JUNE 25, 2011

SET 1" SQUARE IRON PIN  
 IN MONUMENT BOX OVER  
 STONE

