

# OTTAWA COUNTY ENGINEERS OFFICE

REFERENCE NO. 8-7-14-C  
NE CORNER SECTION 8  
BENTON TWP.  
SHEET 1 OF 1.

ROUTE: C-19 GRAYTOWN RD.  
@ T-68 WALBRIDGE E. RD.

TOWNSHIP: BENTON

SECTION: 8

T 7 NR 14 E.


NORTHING:

EASTING:

DATUM:

PERSONNEL:  
M. WITTMAN, P.S.  
J. ALLEN

DATE / WEATHER / TEMP:  
SEPTEMBER 18, 2008  
SUNNY NE  
72° F

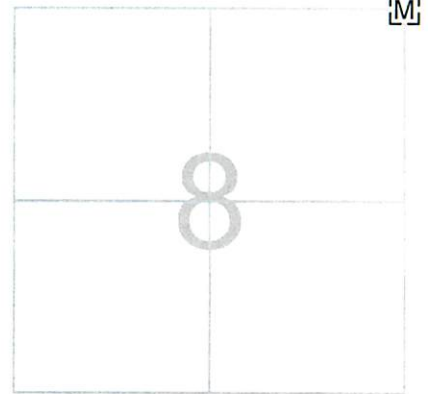

## MONUMENT INFORMATION

MONUMENT TYPE: FD.  $\frac{3}{4}$ " SQ. EXTENSION IRON  
PIN PATCHED IN A ROUND MONUMENT BOX  
ON SURFACE - BELOW: 0.43'  
LEFT - CL PAV'T - RIGHT: 4.90'



## MISC. INFORMATION

SEPTEMBER 18, 2008

SET MONUMENT BOX OVER  
EXISTING PIN IN ROUND  
MONUMENT BOX

