

OTTAWA COUNTY ENGINEERS OFFICE

REFERENCE NO. 8-7-14-D
 WEST QUARTER POST SEC 8
 BENTON TWP.
SHEET 1 OF 1.

ROUTE: C-208 ELLISTON TROWBRIDGE RD
 @ T-39 HAUSENCOMB RD

TOWNSHIP: BENTON

SECTION: 8

T 6 **NR** 14 **E.**


NORTHING:

EASTING:

DATUM:

PERSONNEL:
 M. WITTMAN, P.S.
 J. ALLEN
 J. LAUBACHER

DATE / WEATHER / TEMP:
 JULY 19, 2011
 SUNNY N-NE
 90° F

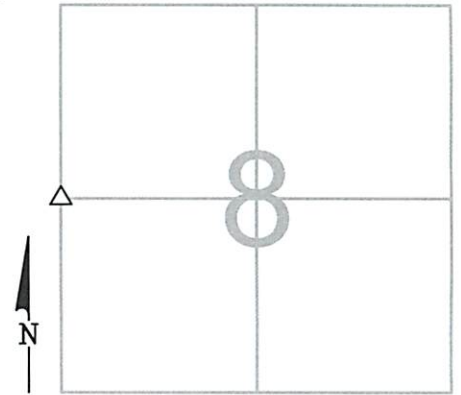

MONUMENT INFORMATION

MONUMENT TYPE: FD 10" X 6 1/2" STONE
 ON SURFACE - BELOW: 1.65'
LEFT - CL PAV'T - RIGHT: 1.30'
 FOOTBALL SHAPED STONE



MISC. INFORMATION

FD RR SPK 0.40' BELOW SURFACE
 TIED W/ X-TIES & DUG FOR STONE
 FD 1" X 1" WOOD HUB 0.66' BELOW SURFACE
 0.05' S OF RR SPK
 RR SPK WAS 0.06' W & 0.14' N OF CENTER OF
 STONE
 USED CENTER OF STONE

JULY 19, 2011

SET 1" SQUARE IRON PIN
 IN MONUMENT BOX OVER
 STONE

