

OTTAWA COUNTY ENGINEERS OFFICE

REFERENCE NO. 8-7-14-E
CENTER POST SEC. 8
BENTON TWP.
SHEET 1 OF 1.

ROUTE: T-39 HAUSENCOMB RD.

TOWNSHIP: BENTON

SECTION: 8

T 7 NR 14 E.


PERSONNEL:
M. WITTMAN, P.S.
J. ALLEN

NORTHING:

EASTING:

DATUM:

DATE / WEATHER / TEMP:
MAY 16, 2017
SUNNY - S-SW
87° F

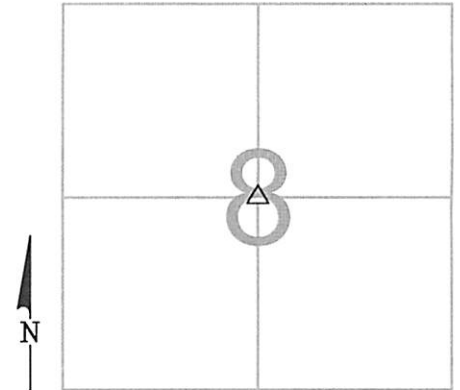

MONUMENT INFORMATION

MONUMENT TYPE: FD. 6" X 4" LIMESTONE
ON SURFACE - BELOW: 0.89'
LEFT - CL PAVT - RIGHT:
SET DRILL HOLE IN CENTER OF STONE.



MISC. INFORMATION

FD. MAG NAIL ON SURFACE W/ 3'-0" PK NAIL TIES
N,S,E & W. TIED WITH GPS AND DUG FOR
STONE.
PK NAIL WAS OVER CENTER OF STONE WHERE
DRILL HOLE WAS SET.

MAY 16, 2017

SET MONUMENT BOX OVER
STONE

