

OTTAWA COUNTY ENGINEERS OFFICE

REFERENCE NO. 8-7-14-H
 SOUTH QUARTER POST SEC. 8
 BENTON TWP.
SHEET 1 OF 1.

ROUTE: T-67 TROWBRIDGE RD.

TOWNSHIP: BENTON

SECTION: 8

T 7 **NR** 14 **E.**

PERSONNEL:
 M. WITTMAN, P.S.
 J. ALLEN


NORTHING:

EASTING:

DATE / WEATHER / TEMP:

JUNE 27, 2013
 SUNNY - HUMID
 72° F

DATUM:

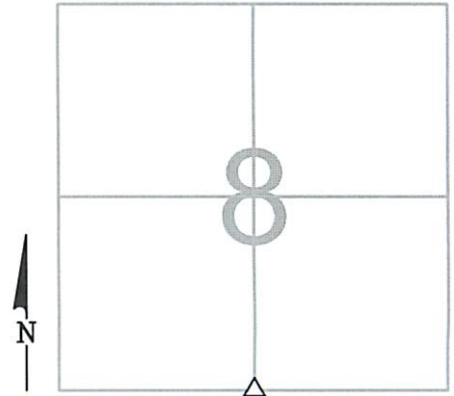

MONUMENT INFORMATION

MONUMENT TYPE: FD 18" x 16" FLAT TOP STONE
 ON SURFACE - BELOW: 0.69'
LEFT - CL PAV'T - RIGHT: 2.00'

STONE IS 18" EW & 16" N/S

SET DRILL HOLE IN STONE



MISC. INFORMATION

APPEARS BY DIMENSIONS OF STONE FOUND AND
 STONE RECORD, THAT STONE FOUND IN 1978 WAS
 NOT FULLY EXCAVATED. SET A DRILL HOLE IN
 STONE WHERE SURFACE PK WAS FOUND AS PK
 DID FIT WITH THE CENTER OF THE STONE.

JUNE 27, 2013

SET MONUMENT BOX OVER
 STONE

