

# OTTAWA COUNTY ENGINEERS OFFICE

REFERENCE NO. 8-7-14-I  
SE CORNER POST SEC. 8  
BENTON TWP.  
SHEET 1 OF 1.

ROUTE: C-19 GRAYTOWN RD.  
@ T-67 TROWBRIDGE RD.

TOWNSHIP: BENTON

SECTION: 8

T 7 N R 14 E.


NORTHING:

EASTING:

DATUM:

PERSONNEL:  
M. WITTMAN, P.S.  
J. ALLEN  
C. MILLER

DATE / WEATHER / TEMP:  
OCTOBER 28, 2010  
OVERCAST - SW  
48° F

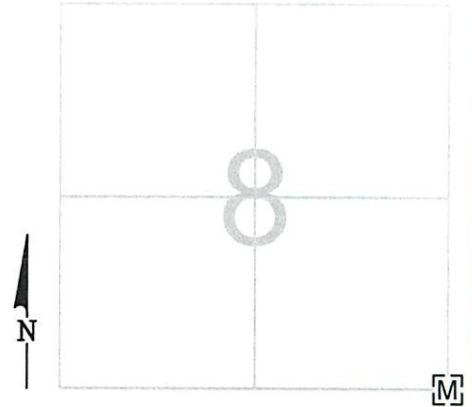

## MONUMENT INFORMATION

MONUMENT TYPE: FD. 1-1/2" Ø IRON PIPE IN  
MOUMENT BOX  
ON SURFACE - BELOW: 0.74'  
LEFT - CL PAV'T - RIGHT: 5.30'



## MISC. INFORMATION

OCTOBER 28, 2010

SET MONUMENT BOX  
OVER EXISTING MONUMENT  
BOX TO BRIGN TO SURFACE

