

OTTAWA COUNTY ENGINEERS OFFICE

REFERENCE NO. 9-7-14-B
NORTH QUARTER POST SEC. 9
BENTON TWP.
SHEET 1 OF 1.

ROUTE: T-68 WALBRIDGE EAST RD.

TOWNSHIP: BENTON

SECTION: 9

T 7 NR 14 E.

PERSONNEL:
M. WITTMAN, P.S.
J. ALLEN


NORTHING:

EASTING:

DATUM:

DATE / WEATHER / TEMP:

JUNE 22, 2015
SUNNY - S
81° F

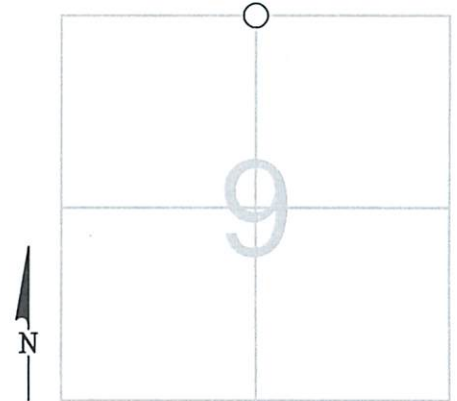

MONUMENT INFORMATION

MONUMENT TYPE: FD 1" Ø IRON PIN
ON SURFACE - BELOW: 0.36'
LEFT - CL PAVT - RIGHT:



MISC. INFORMATION

FD RR SPK 0.14' BELOW SURFACE, TIED W/ X-TIES
AND DUG FOR STONE. FD 1" Ø IRON PIN 0.36'
BELOW SURFACE. RR SPK WAS 0.14' SOUTH AND
ONLONE EAST AND WEST OF IRON PIN. SET
MONUMENT BOX OVER IRON PIN AS IT IS OF
COUNTY RECORD

JUNE 22, 2015

SET MONUMENT BOX OVER
IRON PIN

