

OTTAWA COUNTY ENGINEERS OFFICE

REFERENCE NO. 9-7-14-C
NORTHEAST CORNER SEC. 9
BENTON TWP.
SHEET 1 OF 1.

PERSONNEL:
M. WITTMAN, P.S.
J. ALLEN

DATE / WEATHER / TEMP:
SEPTEMBER 18, 2008
SUNNY NE
70° F

ROUTE: T-21 STANGE RD.
@ T-68 WALBRIDGE E. RD.

TOWNSHIP: BENTON


SECTION: 9

T 7 NR 14 E.

NORTHING:

EASTING:

DATUM:

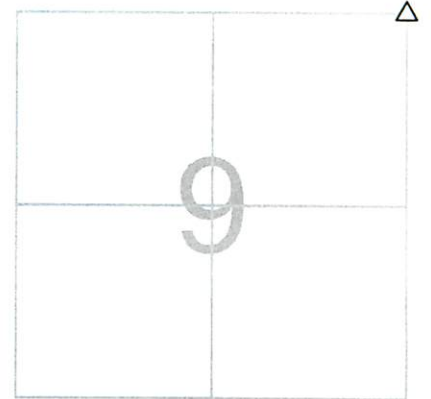

MONUMENT INFORMATION

MONUMENT TYPE: FD STONE W/ DRILL HOLE
ON SURFACE - BELOW: 0.85'
LEFT - CL PAVT - RIGHT:
RECTANGULAR STONE: 14" x 8" TOP



MISC. INFORMATION

SEPTEMBER 18, 2008

SET 1" SQUARE IRON PIN
IN MONUMENT BOX OVER
STONE

