

OTTAWA COUNTY ENGINEERS OFFICE

REFERENCE NO. 9-7-14-D
WEST QUARTER POST SEC. 9
BENTON TWP.
SHEET 1 OF 1.

ROUTE: C-19 GRAYTOWN RD.
@ T-39 HAUSENCOMB RD.

TOWNSHIP: BENTON

SECTION: 9

T 7 NR 14 E.


NORTHING:

EASTING:

DATUM:

PERSONNEL:
M. WITTMAN, P.S.
M. ALLEN

DATE / WEATHER / TEMP:
SEPTEMBER 29, 2008
OVERCAST E
67° F

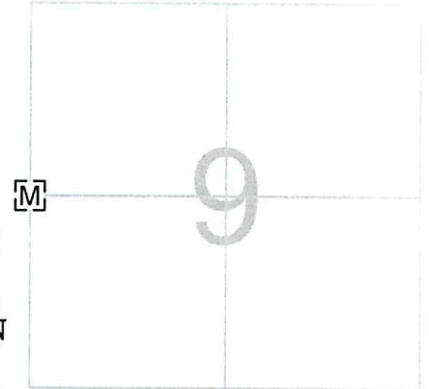

MONUMENT INFORMATION

MONUMENT TYPE: FD 1" SQUARE IRON PIN W/
MUSHROOM TOP IN ROUND MONUMENT BOX
ON SURFACE - BELOW: 0.78'
LEFT - CL PAV'T - RIGHT: 8.30'



MISC. INFORMATION

SEPTEMBER 29, 2008

SET MONUMENT BOX OVER
FD. IRON PIN AND MONUMENT
BOX

