

# OTTAWA COUNTY ENGINEERS OFFICE

REFERENCE NO. 9-7-14-F  
 EAST QUARTER POST SEC. 9  
 BENTON TWP.  
 SHEET 1 OF 1.

ROUTE: T-21 STANGE RD.

TOWNSHIP: BENTON

SECTION: 9

T 7 NR 14 E.

PERSONNEL:  
 M. WITTMAN, P.S.  
 J. ALLEN


NORTHING:

EASTING:

DATE / WEATHER / TEMP:

MAY 3, 2016  
 SUNNY - N  
 59° F

DATUM:

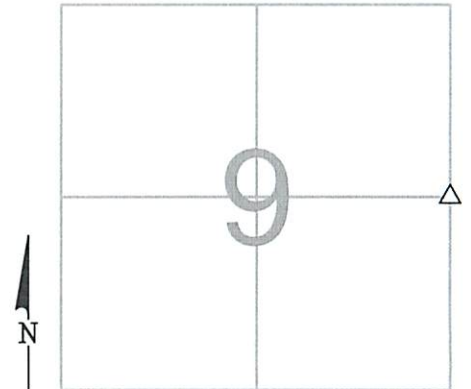

### MONUMENT INFORMATION

MONUMENT TYPE: FD. 6"x6" SQ. POINTED LIMESTONE  
 ON SURFACE - BELOW: 1.73'  
LEFT - CL PAV'T - RIGHT: 7.30'

USED HIGH POINT ON THE HIGH RIDGE OF STONE  
 WHICH IS ON THE EAST THIRD OF THE STONE.



### MISC. INFORMATION

FD. MAG SPIKE ON SURFACE WITH 2'-0" TIES  
 SOUTH AND EAST. TIED WITH X-TIES AND DUG  
 FOR STONE.

MAG SPIKE WAS 0.02' WEST AND 0.01' SOUTH OF  
 POINT USED ON STONE.

MAY 3, 2016

SET 1" SQUARE IRON PIN  
 IN MONUMENT BOX OVER  
 STONE

