

OTTAWA COUNTY ENGINEERS OFFICE

REFERENCE NO. 9-7-14-G
SW CORNER POST SEC. 9
BENTON TWP.
SHEET 1 OF 1.

ROUTE: C-19 GRAYTOWN RD.
@ T-67 TROWBRIDGE RD.

TOWNSHIP: BENTON

SECTION: 9

T 7 NR 14 E.


NORTHING:

EASTING:

DATUM:

PERSONNEL:
M. WITTMAN, P.S.
J. ALLEN
C. MILLER

DATE / WEATHER / TEMP:
OCTOBER 28, 2010
OVERCAST - SW
48° F

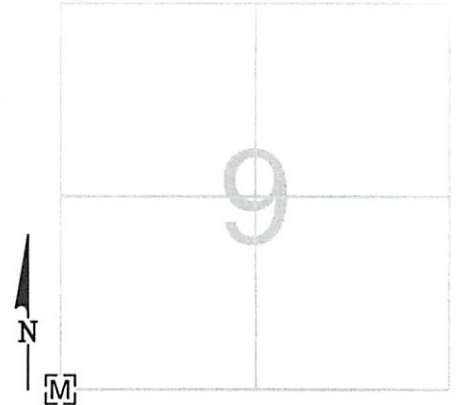

MONUMENT INFORMATION

MONUMENT TYPE: FD. 1-1/2" Ø IRON PIPE IN
MOUMENT BOX
ON SURFACE - BELOW: 0.74'
LEFT - CL PAV'T - RIGHT: 5.30'



MISC. INFORMATION

OCTOBER 28, 2010

SET MONUMENT BOX
OVER EXISTING MONUMENT
BOX TO BRIGN TO SURFACE

