

OTTAWA COUNTY ENGINEERS OFFICE

REFERENCE NO. 9-7-14-H
 SOUTH QUARTER POST SEC 9
 BENTON TWP.
SHEET 1 OF 1.

ROUTE: T-67 TROWBRIDGE RD.

TOWNSHIP: BENTON

SECTION: 9

T 7 **NR** 14 **E.**


PERSONNEL:
 M. WITTMAN, P.S.
 J. ALLEN

NORTHING:

EASTING:

DATE / WEATHER / TEMP:
 JUNE 20, 2011
 OUTCAST HUMID
 70° F

DATUM:

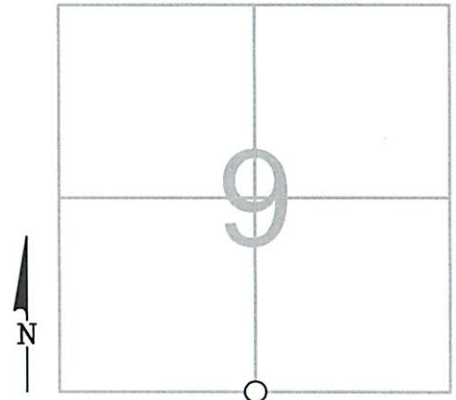

MONUMENT INFORMATION

MONUMENT TYPE: RAILROAD SPIKE
 ON SURFACE - BELOW: 0.24'
 LEFT - CL PAV'T - RIGHT:



MISC. INFORMATION

TIED W/ X-TIES & DUG FOR STONE PER DEWITT 1893
 DID NOT FIND STONE
 SHOT FROM X-TIES FROM RR SPK
 TO WEST 2676.99' (2677 R) IP IN MON BOX
 TO EAST 2675.52' (2675.25R) IP IN MON BOX
 INT \angle 179° 51'26" (179°52'R)
 ACCEPTED RAILROAD SPIKE

JUNE 21, 2011

RESET 1" SQUARE IRON PIN
 IN MONUMENT BOX

