

OTTAWA COUNTY ENGINEERS OFFICE

REFERENCE NO. 11-7-15-I
SE CORNER POST SEC. 11
CARROLL TWP.
SHEET 1 OF 1.

ROUTE: C-104 TOUSSAINT SOUTH RD.

TOWNSHIP: CARROLL

SECTION: 11

T 7 NR 15 E.

PERSONNEL:
M. WITTMAN, P.S.
J. ALLEN


NORTHING:

EASTING:

DATUM:

DATE / WEATHER / TEMP:

MARCH 19, 2012
SUNNY
75° F

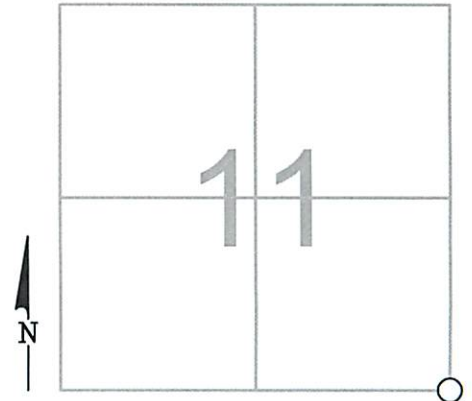

MONUMENT INFORMATION

MONUMENT TYPE: FD. 1" SQ. IRON PIN W/ DH
ON SURFACE - BELOW: 0.39'
LEFT - CL PAV'T - RIGHT: 1.35'



MISC. INFORMATION

MARCH 19, 2012

SET MONUMENT BOX OVER
1" SQUARE IRON PIN

